

TRINITY BLACKFRIARS Excavated by: M.B. S.T. Grid Reference: (E, N) Provisional Period: early 19th C	Site: TRINITY BLACKFRIARS	Code: TB17	Fill/Layer Record Sheet	(161) (026)
	Excavated by: M.B. S.T.	Date: 11-18th May	Recorded by: M.B.	Date: 19/5/17
	Grid Reference: (E, N)	Checked by:	Continued	
	Provisional Period: early 19th C			

1) Texture: H/M BRICK	Contained By:
2) Colour:	
3) Consistency: WALL	
4) Dimensions: Length:	
Width:	
Depth:	
5) Inclusions: sandy mortar.	
6) Disturbance:	
7) Description and Discussion: EARLY 19th C H/M BRICK WALL	
uncertain of function but seems to pre-date	
rest of walls in E. side of trench. Cut into	
natural (004). may be truncated at S. end by	
later drains (032), (033)	
Rear wall of Southern-most house in row fronting	
Brussels St. on 1851, 1890 + 1908 maps	

Stratigraphy:		Cut By: [033]?	
Stratigraphically Earlier than:	☐ [032] [033] ☐ ☐		
This context is:	[026]		
Stratigraphically Later than:	☐ ☐ [004] ☐ ☐	Cuts: (004)	

Finds:	Inorganic	Pottery	Metal	Glass	Stone	Brick/Tile	Organic	Wood	Leather	Bone	Charcoal	Other
Tick if present:							Tick if present:					
Tick if collected:							Tick if collected:					

Samples:	Tick if taken: ☐	Small Finds:
Sample No: Type: Quantity: Context:		☐ ☐ ☐ ☐
Sample No: Type: Quantity: Context:		
Sample No: Type: Quantity: Context:		

Photographs:	Drawings:
Digital Film No: Shot No's:	Plan Drawing No: Sheet No:
Slide Film No: Shot No's:	Section Drawing No: Sheet No:

Provisional Interpretation:	

Sketch Section:

Levels


TMB___: m

BS: m

FS: m

RL: m

Sketch Plan:

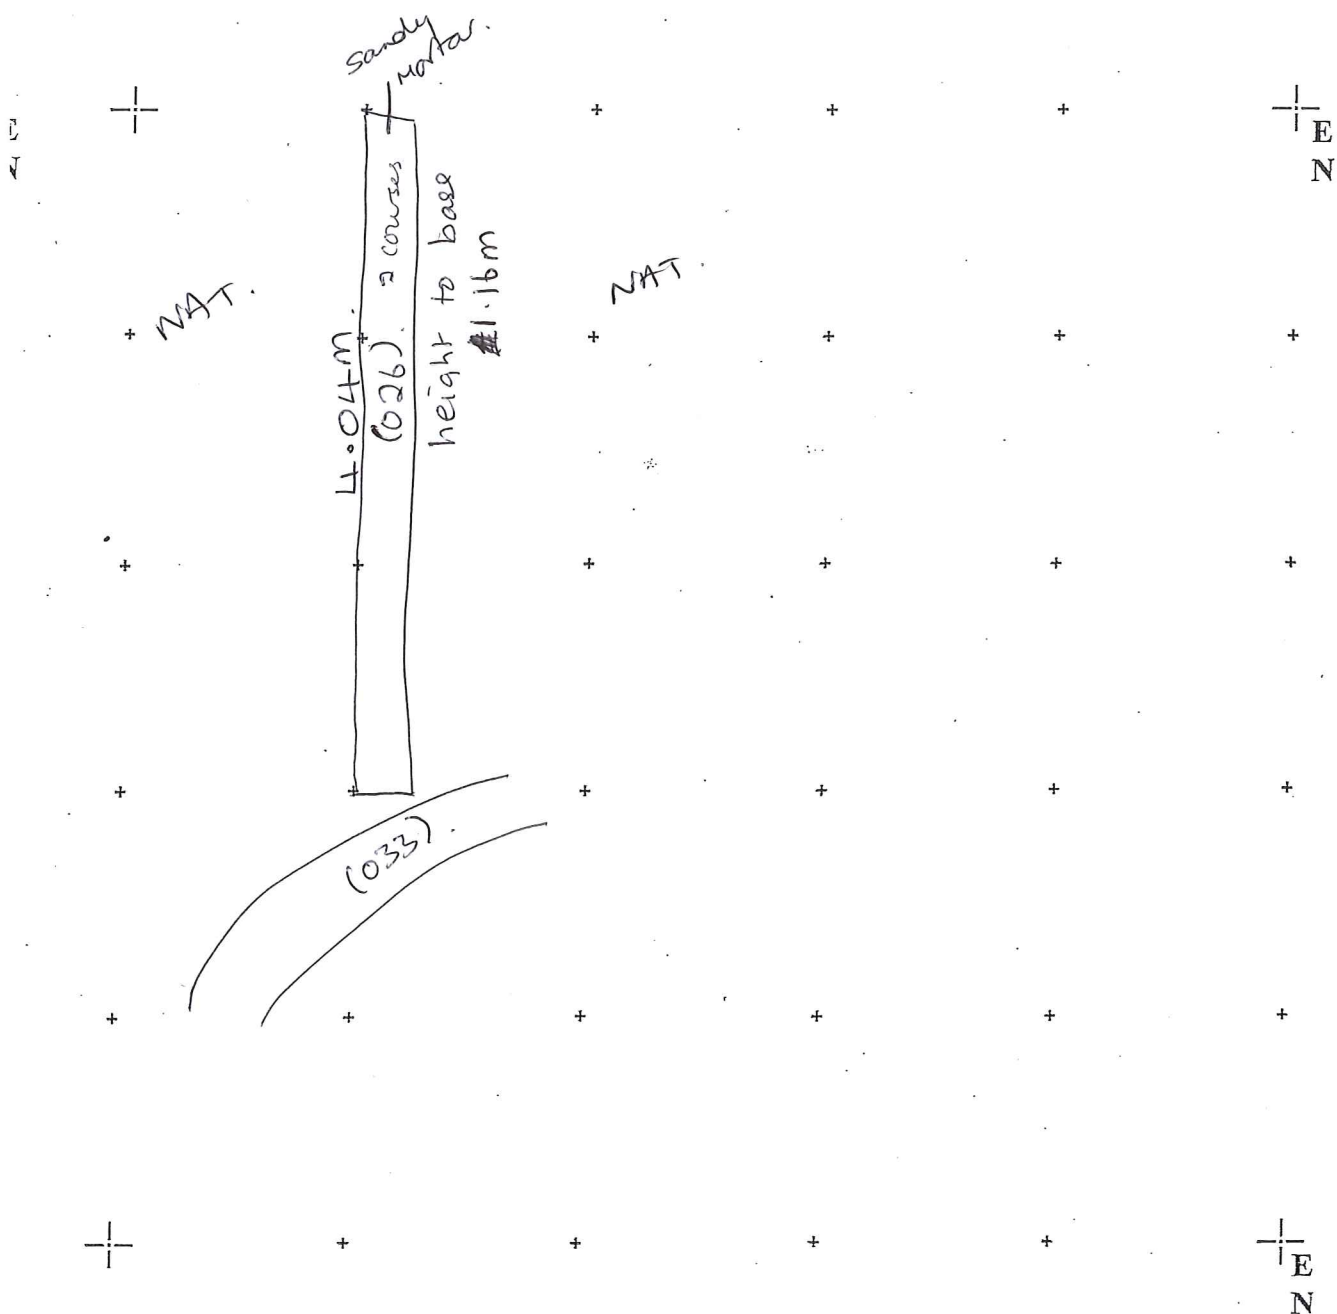

Excavation Record Sheet	Site: <u>TRINITY BLACKFRIARS</u>	Code: <u>TB17</u>	Fill/Layer Record Sheet		(155) (020)
	Excavated by: <u>M.B. S.J.H. S.T.</u>	Date: <u>11-18th May</u>	Recorded by: <u>M.B.</u>		Date: <u>18/5/17</u>
	Grid Reference: (E , N)		Checked by:		Continued
	Provisional Period: <u>late 19th C</u>				

1) Texture: <u>H/M BRICK</u>	Bricks: <u>23x11x7.</u>	Contained By:
2) Colour:		
3) Consistency: <u>STRUCTURE</u>		
4) Dimensions: Length:		
Width:		
Depth: <u>1.34m total exc.</u>		
5) Inclusions: <u>black-ash mortar</u>		
6) Disturbance:		
7) Description and Discussion: <u>ROOM 3 E of BRUSSELL ST.</u>		
<u>Southern-most room excavated at E end of trench located E of Brussell St. (010). Appeared to be H/M brick with black-ash mortar. Top 1-2 courses possibly belong to former garage which might have been built on top. W wall - the E-facing elevation contained 2 brick pillars likely to be f.p./chimney foundation. Deep wall, base found sitting on red sand. Probably front wall of houses. N wall - 1 course wide - sat on conc. foundation. 0.45m wide</u>		

Stratigraphy: Stratigraphically Earlier than: This context is: 020 Stratigraphically Later than:	Cut By: Cuts:
--	--------------------------

Finds:	Inorganic	Pottery	Metal	Glass	Stone	Brick/Tile	Organic	Wood	Leather	Bone	Charcoal	Other
Tick if present:	☒						Tick if present:					
Tick if collected:	☒						Tick if collected:					

Samples: Sample No: Type: Quantity: Context: Sample No: Type: Quantity: Context: Sample No: Type: Quantity: Context:	Tick if taken: ☐	Small Finds:
---	---	--

Photographs: Digital Film No: Shot No's: Slide Film No: Shot No's:	Drawings: Plan Drawing No: Sheet No: Section Drawing No: Sheet No:
---	---

Provisional Interpretation:	
------------------------------------	--

Sketch Section:

Levels

TMB___: m

BS: m


FS: m

RL: m

Sketch Plan: Room 3

N.t.S.

Surviving floor 0.08m thick

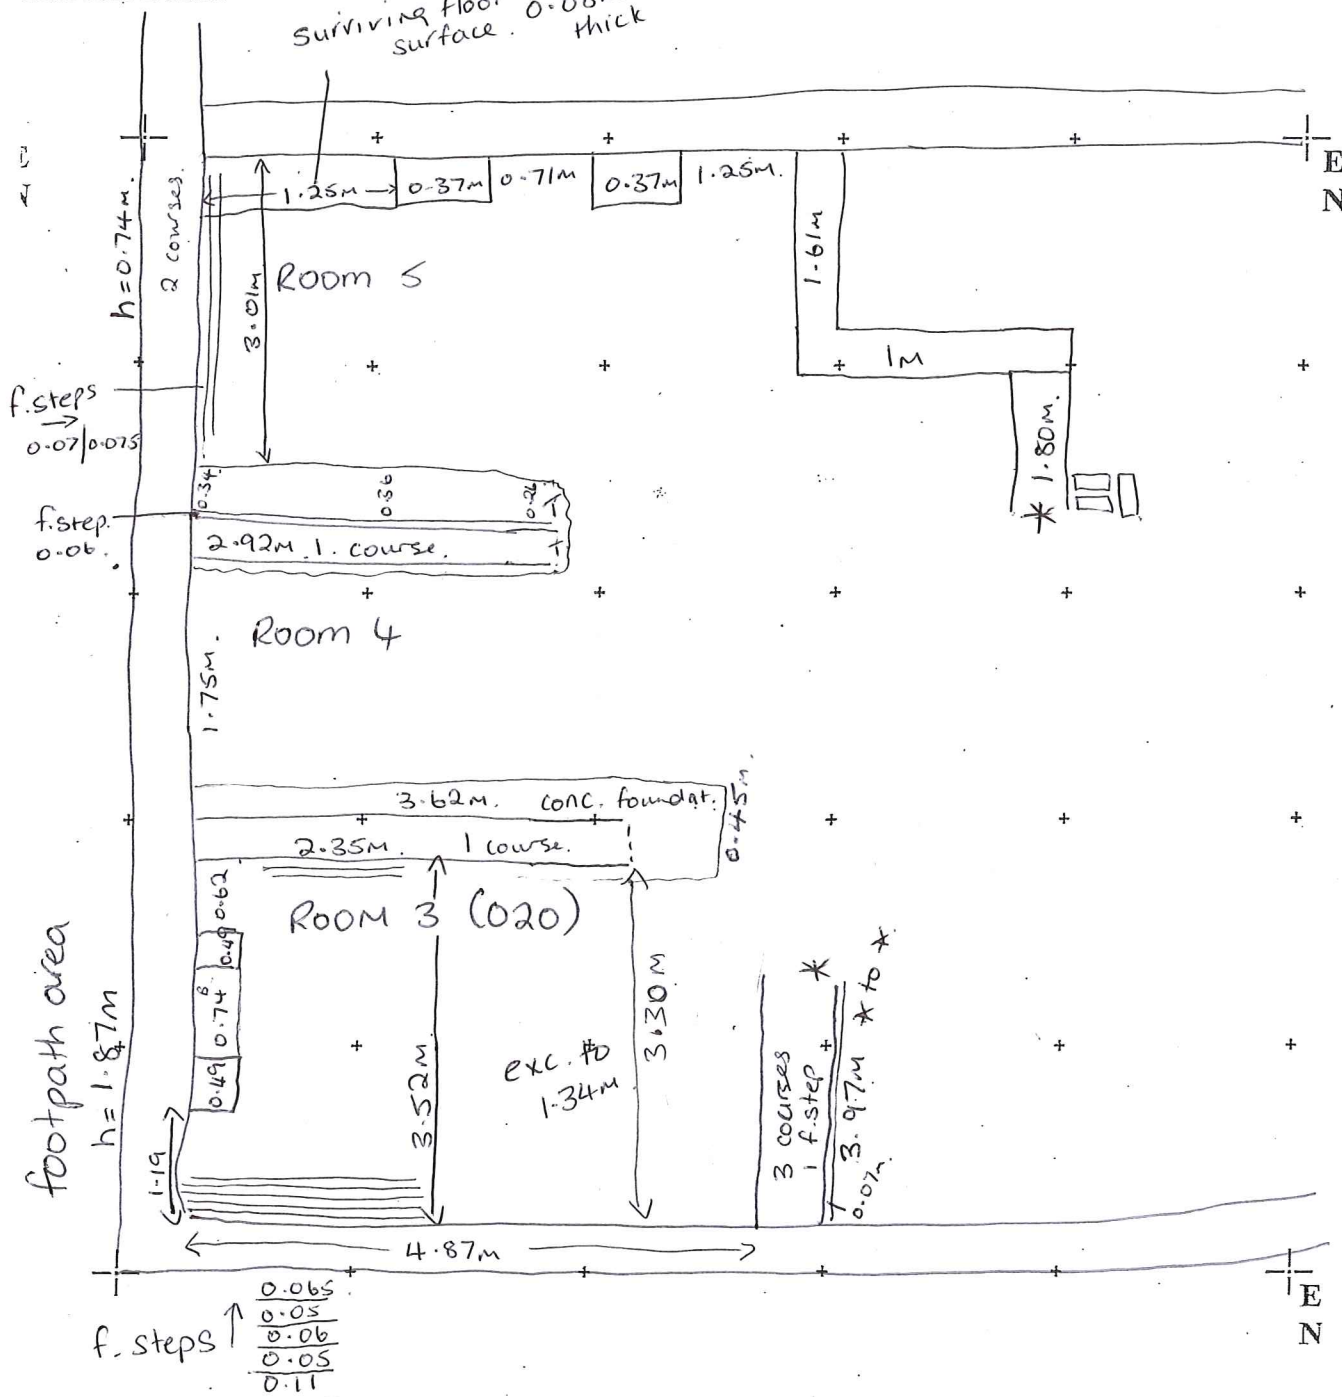

TRINITY BLACKFRIARS M.B. S.T.	Site: TRINITY BLACKFRIARS	Code: TB17	Fill/Layer Record Sheet	(152) (017)
	Excavated by: M.B. S.T.	Date: 11-18th May	Recorded by: M.B.	Date: 18/5/17
	Grid Reference: (E, N)		Checked by:	Continued
	Provisional Period: 19th C			

1) Texture: H/M BRICK	Contained By:
2) Colour:	
3) Consistency: STRUCTURE	
4) Dimensions: Length: N-S = 1.17m - interior 0.73m	
Width: E-W = 0.92 - interior 0.53m	
Depth: not exc. Cut = 0.12m.	
5) Inclusions: sandy mortar with hard grey mortar on top.	
6) Disturbance:	
7) Description and Discussion: MAN-HOLE BELOW BRUSSELL ST. Rectangular man-hole in the location of a missing part of Brussell St, shown on 1890 map. Cut [018] appeared on all sides. [153]	

Stratigraphy:							Cut By:
Stratigraphically Earlier than:							
This context is:	016					Cuts:	
Stratigraphically Later than:	018						

Finds:	Inorganic	Pottery	Metal	Glass	Stone	Brick/Tile	Organic	Wood	Leather	Bone	Charcoal	Other
Tick if present:							Tick if present:					
Tick if collected:							Tick if collected:					

Samples:	Tick if taken: ☐	Small Finds:
Sample No: Type: Quantity: Context:		
Sample No: Type: Quantity: Context:		
Sample No: Type: Quantity: Context:		

Photographs:	Drawings:
Digital Film No: Shot No's:	Plan Drawing No: Sheet No:
Slide Film No: Shot No's:	Section Drawing No: Sheet No:

Provisional Interpretation:	

Sketch Section:

Levels


TMB___: m

BS: m

FS: m

RL: m

Sketch Plan:

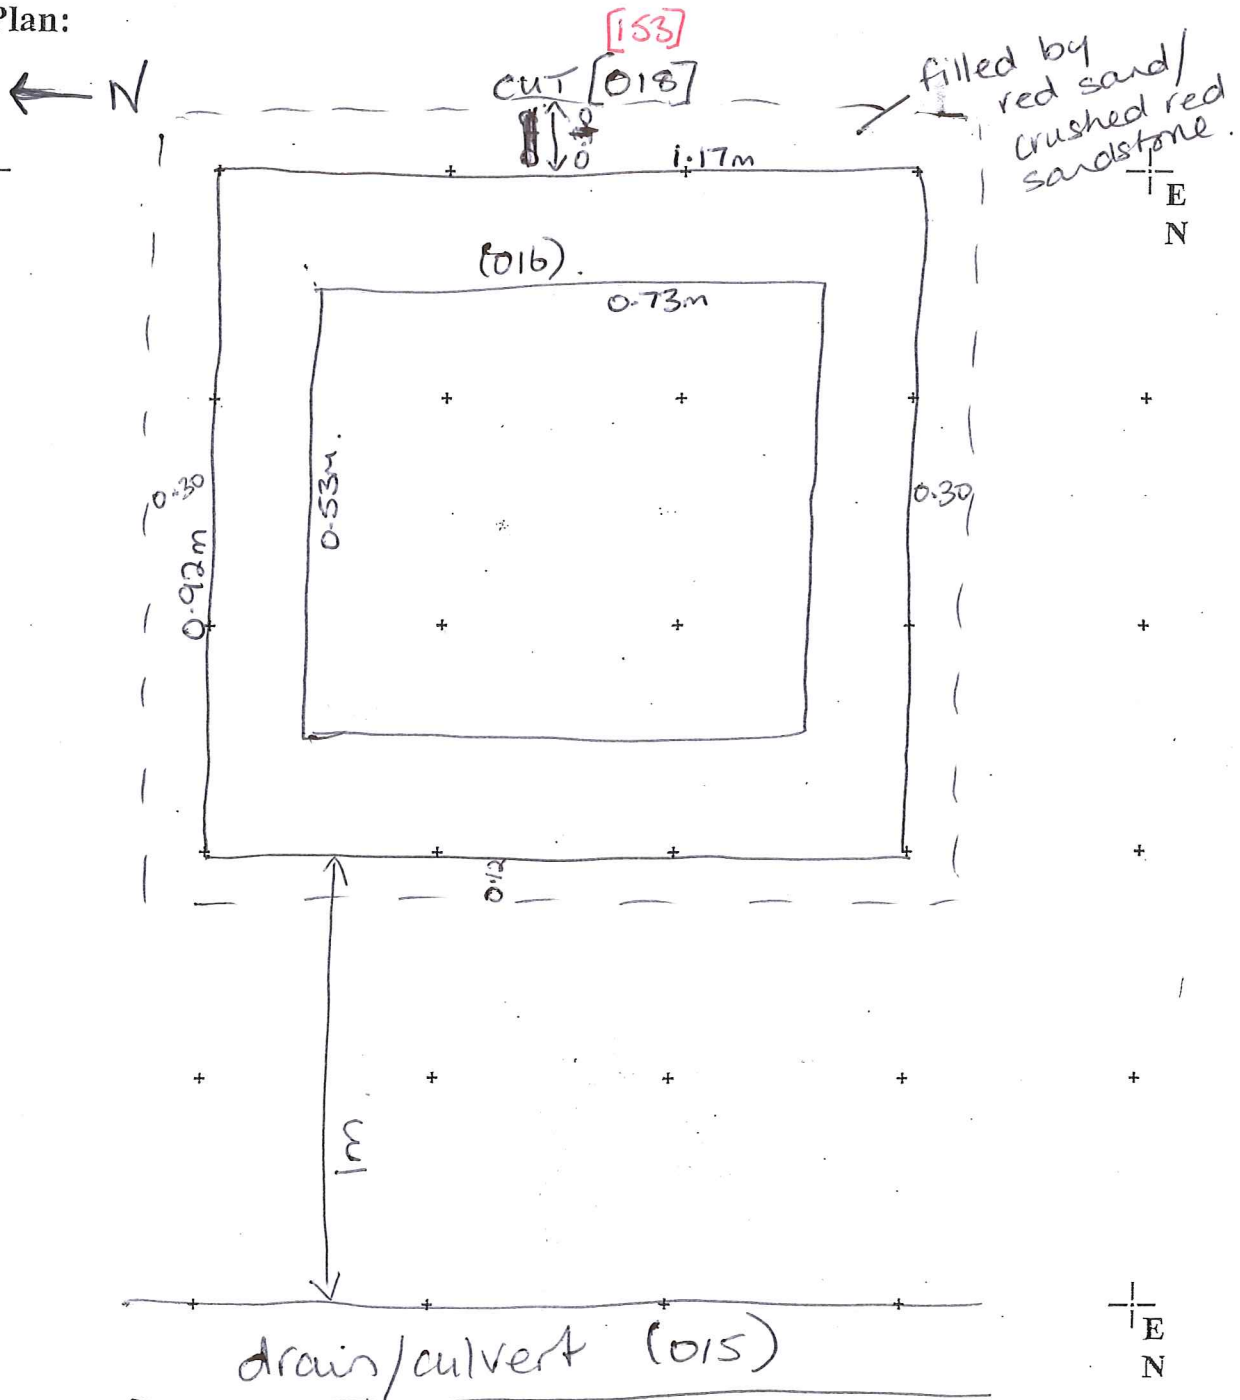

	Site: TRINITY BLACKFRIARS	Code: TB17	Fill/Layer Record Sheet	(150) (015)
	Excavated by: M.B. S.H. S.T.	Date: 11-18th May	Recorded by: M.B.	Date: 18/5/17
	Grid Reference: (E , N)		Checked by:	Continued
	Provisional Period: 19th C			

1) Texture: H/M BRICK + STONE	Cobbles.	Contained By:
2) Colour:	Clndee 0.06m	
3) Consistency: DRAIN/CULVERT-STRUCTURE	Re-dep 0.42m	
4) Dimensions: Length: 3.47m exc.	0-65m from cobb surf.	
Width: 0.58m cap stone		
Depth: 0.32m brick/height + stone cap = 0.08m.		
5) Inclusions:		
6) Disturbance:		
7) Description and Discussion: BRICK + STONE DRAIN/CULVERT		
Inside brick section = 0.31m wide		
Aligned E-W, below cobbled surface. Consists of		
brick base + sides capped with stone flags.		
Cut [016] visible on N side		

Stratigraphy:		Cut By:
Stratigraphically Earlier than:		
This context is:		Cuts:
Stratigraphically Later than:		

Finds:	Inorganic	Pottery	Metal	Glass	Stone	Brick/Tile	Organic	Wood	Leather	Bone	Charcoal	Other
Tick if present:							Tick if present:					
Tick if collected:							Tick if collected:					

Samples:	Tick if taken: ☐	Small Finds:
Sample No: Type: Quantity: Context:		
Sample No: Type: Quantity: Context:		
Sample No: Type: Quantity: Context:		

Photographs:	Drawings:
Digital Film No: Shot No's:	Plan Drawing No: Sheet No:
Slide Film No: Shot No's:	Section Drawing No: Sheet No:

Provisional Interpretation:	

Sketch Section:


Levels

TMB___: m


BS: m

FS: m

RL: m

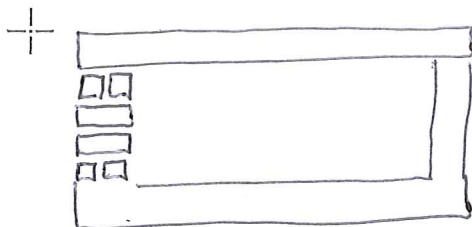

Sketch Plan: (015)

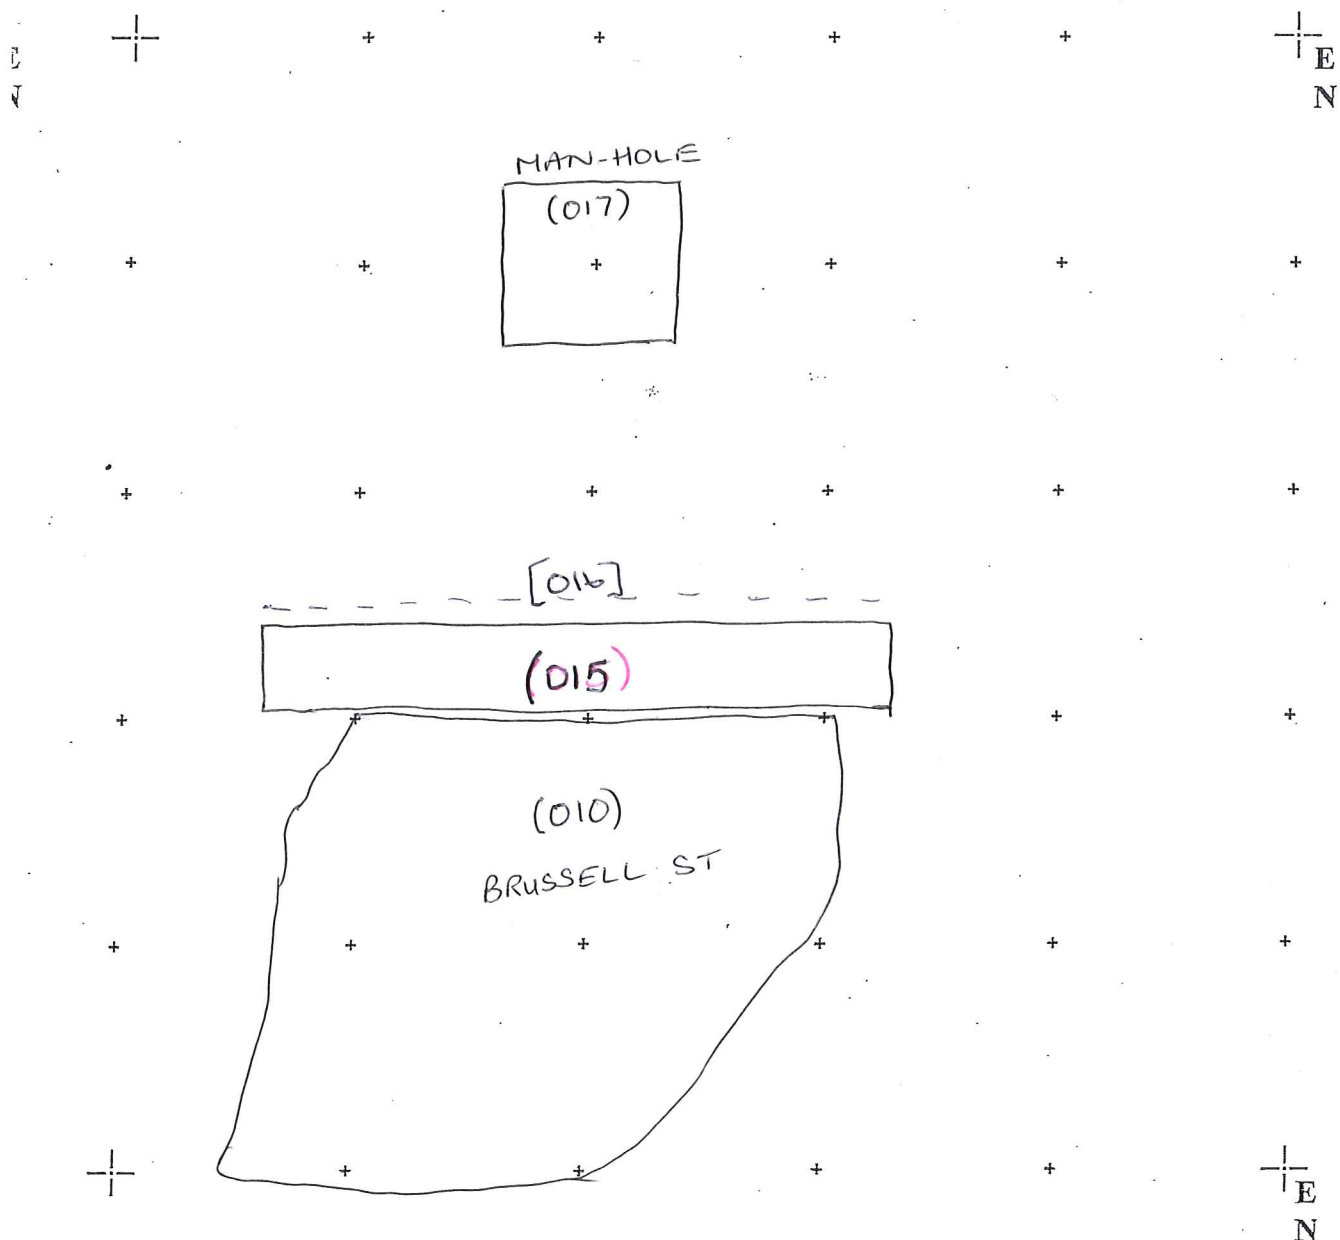

The Centre for Applied Archaeology	Site: TRINITY BLACKFRIARS	Code: TB17	Fill/Layer Record Sheet (143) (008)	
	Excavated by: M.B. S.S.H. S.T.	Date: 11-18th May	Recorded by: M.B.	Date: 18/5/17
	Grid Reference: (E, N)		Checked by:	Continued
	Provisional Period: early 19th C			

1) Texture: H/M BRICK	Bricks 23x11x7	Contained By:
2) Colour:		
3) Consistency: STRUCTURE	Steps	
4) Dimensions: Length: 2.08m E-W	l = 0.75	
Width: 1.66m N-S	w = 0.22	
Depth:	d = 0.25	
5) Inclusions: sandy lime mortar.	0.045 thick	
6) Disturbance:		
7) Description and Discussion: EXTERNAL STAIRWELL		
External staircase structure on the N wall of both cellars 1 & 2. Steps lead down from N→S. Doorway into room has been bricked-up. Exterior walls 2 brick-courses wide, internal wall-single course. Stone steps rest on 2 brick courses (dimensions above) bonded with sandy mortar. Bottom 3 steps into cellar 1 excavated. Wall cut (012) visible on N + E sides cut into (004). Lrg. stone blocks found probably from doorway of floor above.		

Stratigraphy: Stratigraphically Earlier than: This context is: 008 Stratigraphically Later than: 004	Cut By: Cuts: 004
--	--------------------------

Finds:	Inorganic	Pottery	Metal	Glass	Stone	Brick/Tile	Organic	Wood	Leather	Bone	Charcoal	Other
Tick if present:		✓			✓		Tick if present:					
Tick if collected:		✓					Tick if collected:					

Samples: Sample No: Type: Quantity: Context: Sample No: Type: Quantity: Context: Sample No: Type: Quantity: Context:	Tick if taken: ☐	Small Finds:
---	---	---

Photographs: Digital Film No: Shot No's: Slide Film No: Shot No's:	Drawings: Plan Drawing No: Sheet No: Section Drawing No: Sheet No:
---	---

Provisional Interpretation:	
------------------------------------	--

Sketch Section:

Levels


TMB___: m

BS: m

FS: m

RL: m

Sketch Plan:

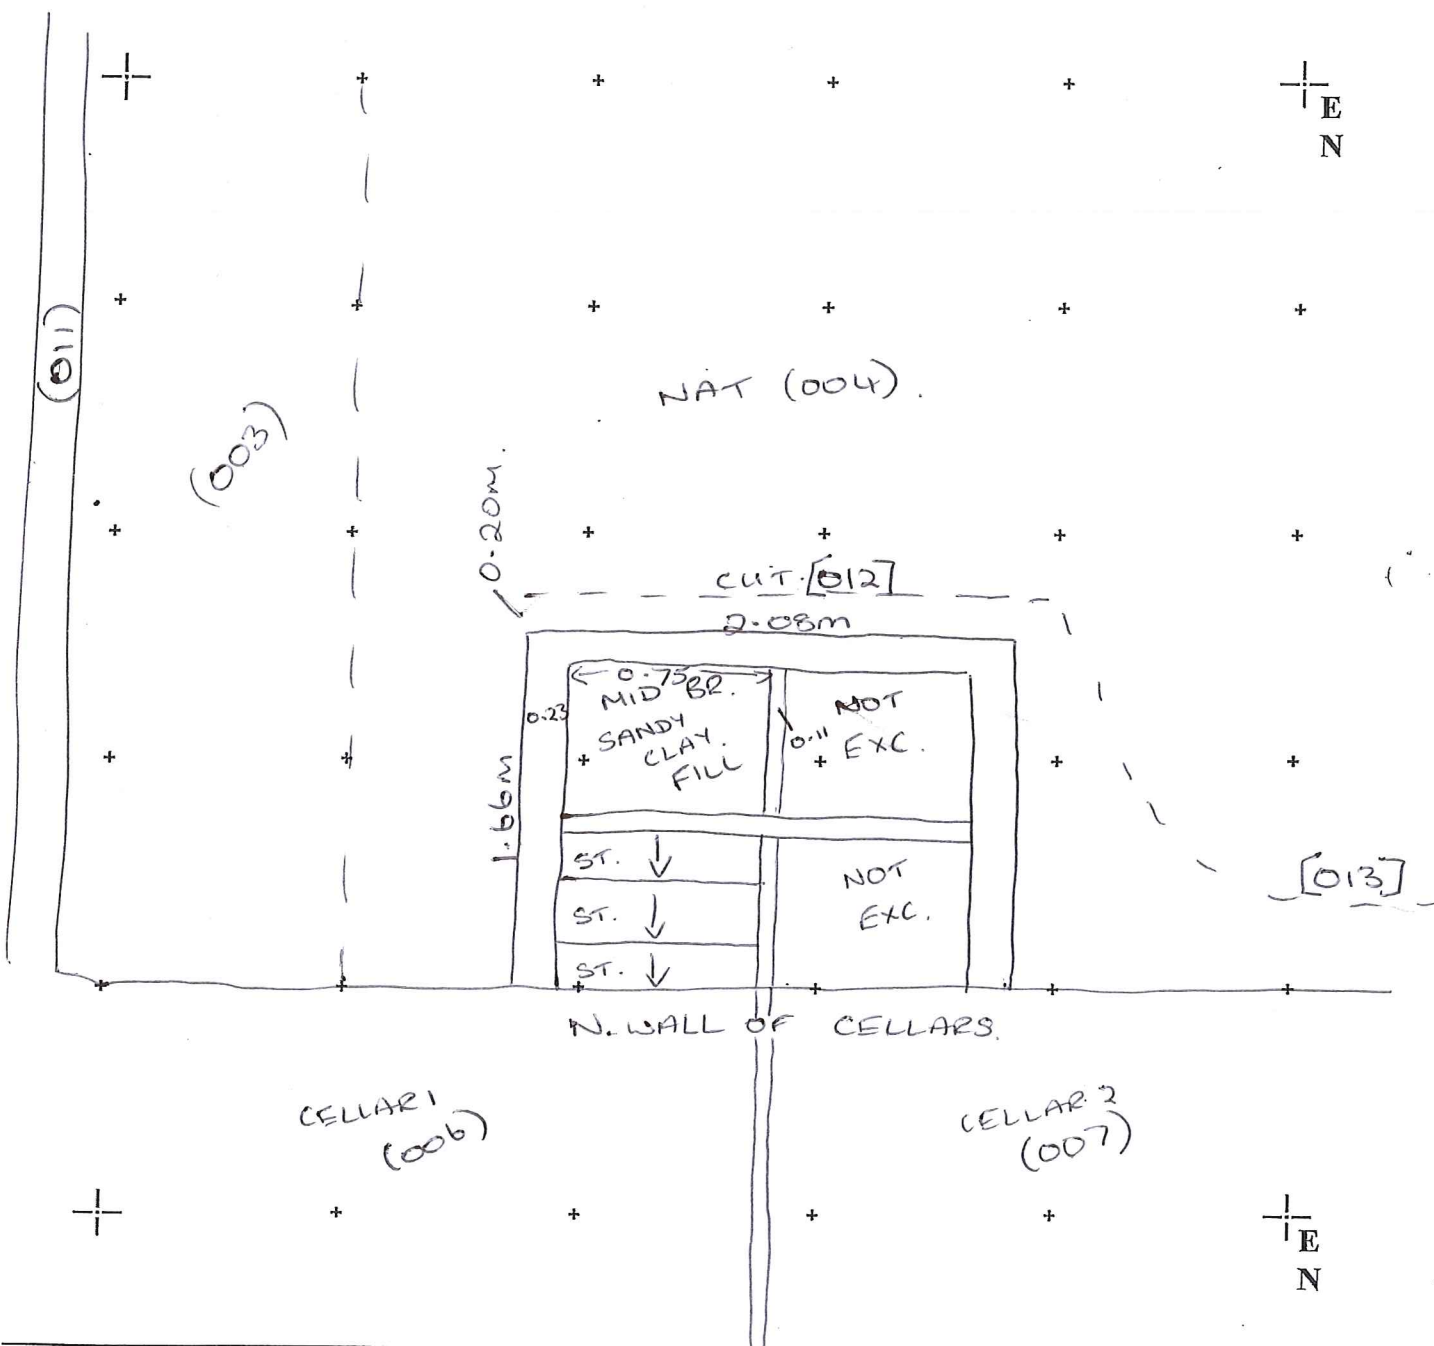

TRINITY BLACKFRIARS	Site: TRINITY BLACKFRIARS	Code: TB17	Fill/Layer Record Sheet	(145) (010)
	Excavated by: M.B. S.S.H. S.T.	Date: 11-18th May	Recorded by: M.B.	Date: 18/5/17
	Grid Reference: (E, N)		Checked by:	Continued
	Provisional Period: 19th C			

1) Texture: stone	Contained By:
2) Colour:	
3) Consistency: cobbled road	
4) Dimensions: Length: 4.22m E-W (max excavated/surviving)	
Width: 3.56m N-S (" " " ")	
Depth: 0.21max (cobbles)	
5) Inclusions: set into black cinder	
6) Disturbance: Truncated to North.	
7) Description and Discussion: BRUSSELL ST. COBBLED ROAD.	
Covered by modern tarmac 1cm thick, Surviving section of stone-cobbled BRUSSELL STREET. Cobbles laid E-W to N & N-S to S - could be junction with road to South? Footpath area to W - surface missing - measures 1.62m to E wall of Cellar 2. Road aligned N-S. Appears truncated at N. end where culvert/drain (015) & man-hole (017) were found. Surface continued 3 under modern tarmac.	

Stratigraphy:		Cut By:
Stratigraphically Earlier than:		
This context is:	010	Cuts:
Stratigraphically Later than:		

Finds:	Inorganic	Pottery	Metal	Glass	Stone	Brick/Tile	Organic	Wood	Leather	Bone	Charcoal	Other
Tick if present:							Tick if present:					
Tick if collected:							Tick if collected:					

Samples:	Tick if taken: ☐	Small Finds:
Sample No: Type: Quantity: Context:		
Sample No: Type: Quantity: Context:		
Sample No: Type: Quantity: Context:		

Photographs:	Drawings:
Digital Film No: Shot No's:	Plan Drawing No: Sheet No:
Slide Film No: Shot No's:	Section Drawing No: Sheet No:

Provisional Interpretation:

Sketch Section:

Levels


TMB___: m

BS: m

FS: m

RL: m

Sketch Plan:

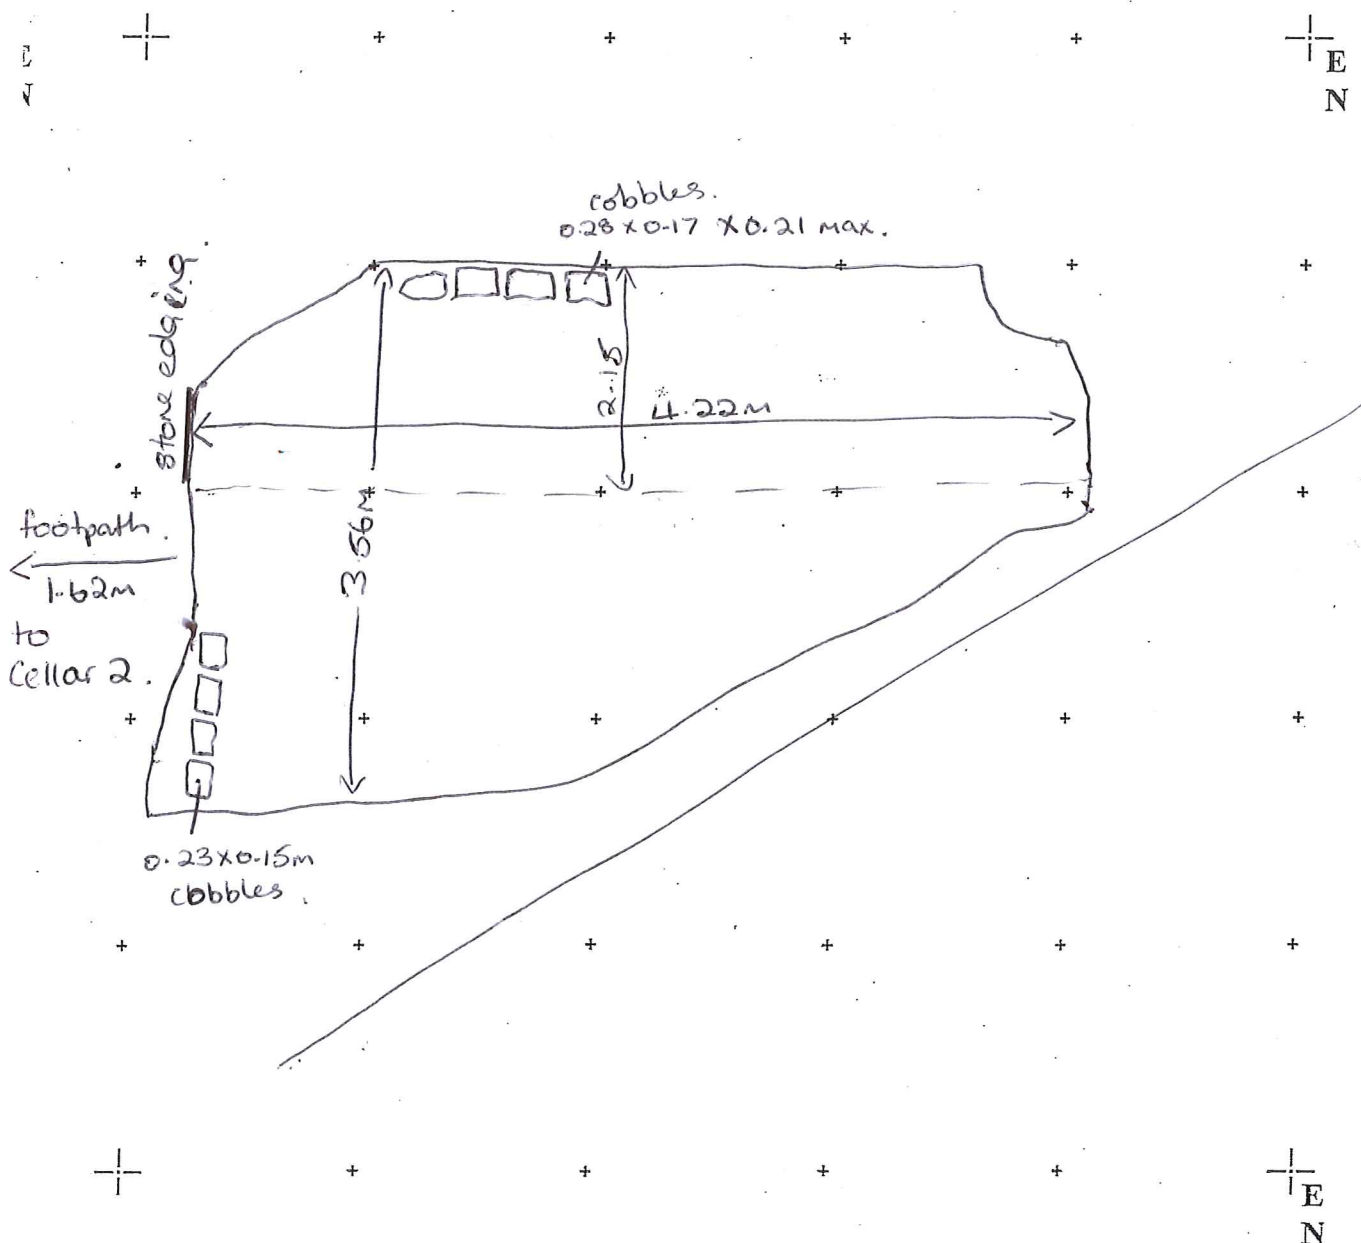


Applied Archaeology University of Southampton	Site: TRINITY BLACKFRIARS	Code: TB17	Fill/Layer Record Sheet	(146) (011)
	Excavated by: M.B. S.J.H. S.T.	Date: 11-18th May	Recorded by: M.B.	Date: 18/5/17
	Grid Reference: (E, N)		Checked by:	Continued
	Provisional Period: late 19th c			

1) Texture: H/M BRICK	Contained By:
2) Colour:	
3) Consistency: WALL	
4) Dimensions: Length: 5.61m N-S surviving Width: 0.24m Depth: not exc.	
5) Inclusions: black mortar.	
6) Disturbance:	
7) Description and Discussion: POSS. OUTSIDE WALL Wall continues N along same alignment as W wall of Cellar 1. Appears later than cellars - has black ash mortar. Built onto natural (004). Poss. trunc truncated at N end but appears to have returned E as a small section survived. No floor surface appeared to E - only nat (004). Toilet area + alleyway located to W. (003) appeared to fill either side of wall E + W.	

Stratigraphy: Stratigraphically Earlier than: 003 This context is: 011 Stratigraphically Later than: 006 007					Cut By:
					Cuts:

Finds:	Inorganic	Pottery	Metal	Glass	Stone	Brick/Tile	Organic	Wood	Leather	Bone	Charcoal	Other
Tick if present:							Tick if present:					
Tick if collected:							Tick if collected:					

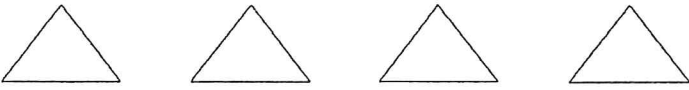Samples: Sample No: Type: Quantity: Context: Sample No: Type: Quantity: Context: Sample No: Type: Quantity: Context:	Tick if taken: ☐	Small Finds: 
--	---	---

Photographs: Digital Film No: Shot No's: Slide Film No: Shot No's:	Drawings: Plan Drawing No: Sheet No: Section Drawing No: Sheet No:
---	---

Provisional Interpretation:

Sketch Section:

Levels


TMB___: m

BS: m

FS: m

RL: m

Sketch Plan: (014)

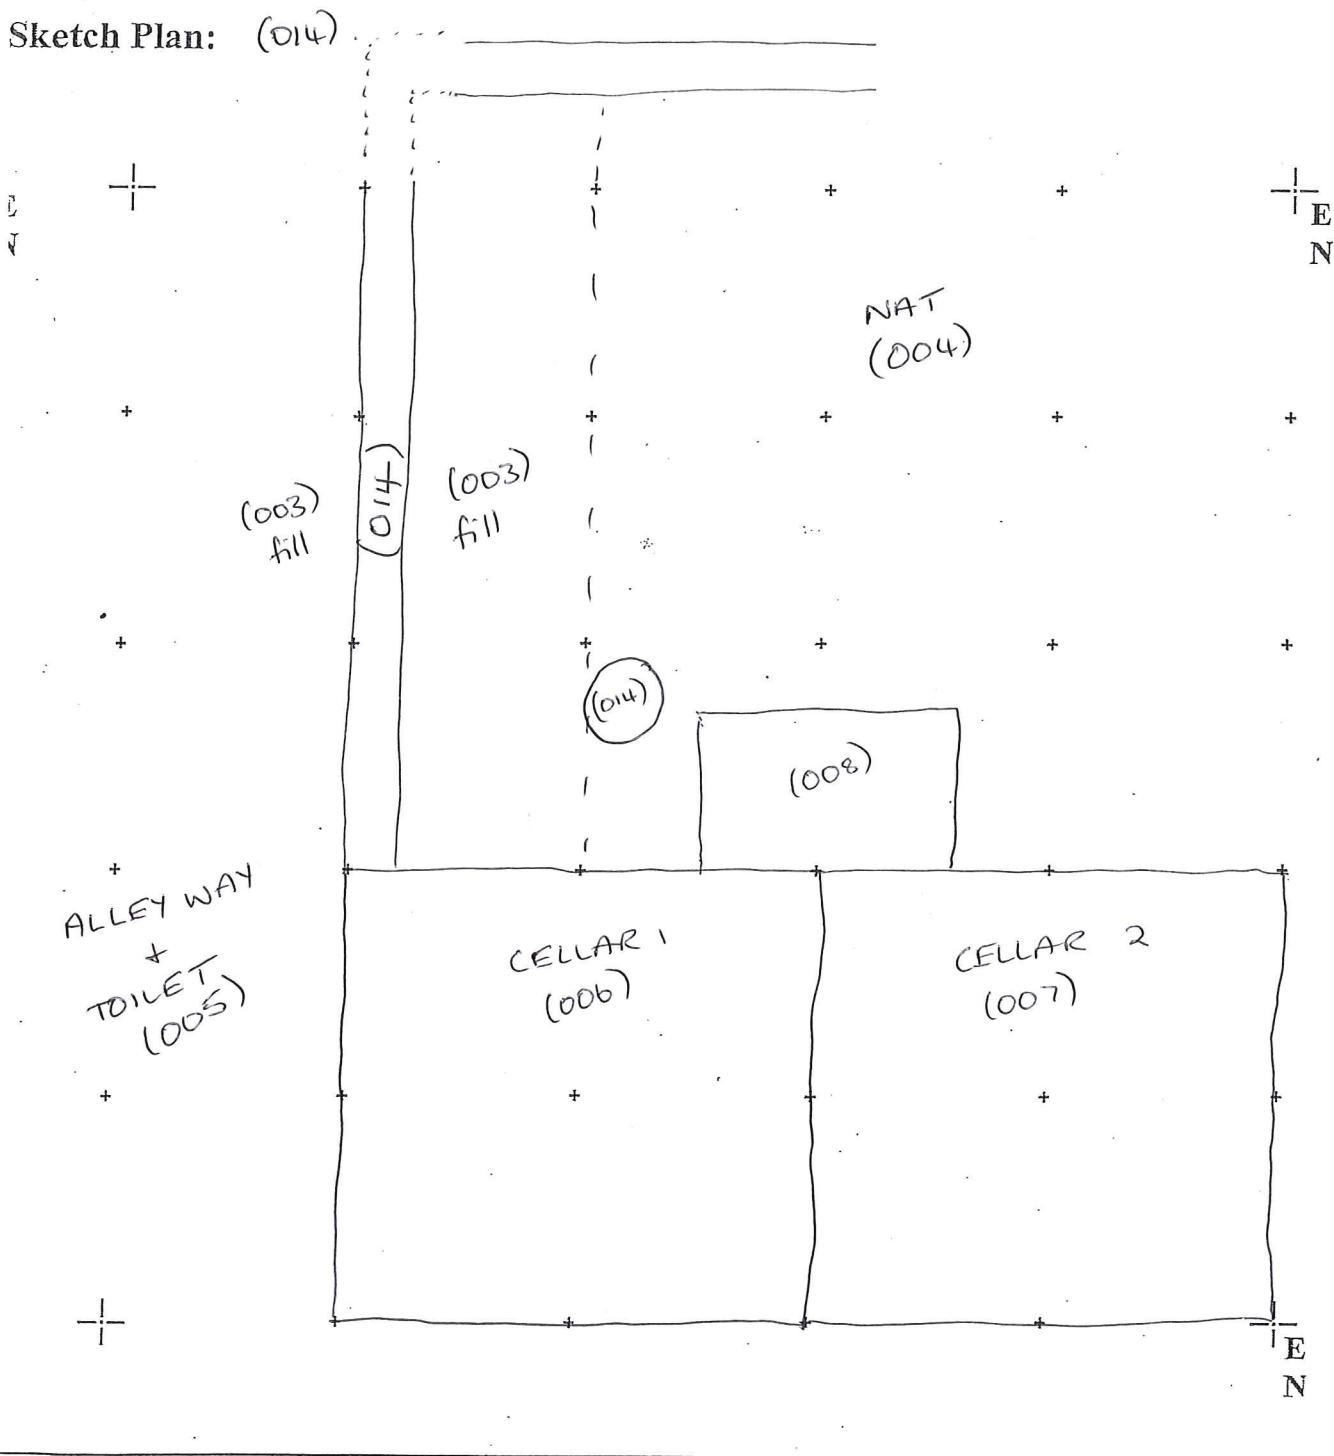

The Centre for Applied Archaeology	Site: TRINITY BLACKFRIARS	Code: TB17	Fill/Layer Record Sheet	(142) (007.)
	Excavated by: M.B. S.S.H. S.T.	Date: 11-18th May	Recorded by: M.B.	Date: 18/5/17
	Grid Reference: (E, N)	Checked by:	Continued	
	Provisional Period: 19th C			

1) Texture: H/M BRICK	Bricks 23x11x7cm	Contained By:
2) Colour:		
3) Consistency: STRUCTURE		
4) Dimensions: Length: E-W = 3.97m (interior)		
Width: N-S = 3.40m (")		
Depth: 1.28m surviving height		
5) Inclusions: sandy shell mortar, black ash mortar		
6) Disturbance:		
7) Description and Discussion: CELLAR 2.		
Cellar room E. of Cellar 1 separated by single-course wide H/M brick wall. F.p. on W wall - later bricked-up + sink added. Bricked up doorway in N. wall with black-ash mortar. Entrance was via external staircase (008) N. of N. wall.		

Stratigraphy:		Cut By:
Stratigraphically Earlier than:		
This context is:	007	
Stratigraphically Later than:	004	Cuts: 004

Finds: Inorganic	Pottery	Metal	Glass	Stone	Brick/Tile	Organic	Wood	Leather	Bone	Charcoal	Other
Tick if present:	☒	☒	☒	☒	☐	Tick if present:	☒	☐	☐	☐	☐
Tick if collected:	☒	☒	☒	☐	☐	Tick if collected:	☐	☐	☐	☐	☐

Samples:	Tick if taken: ☐	Small Finds:
Sample No: Type: Quantity: Context:		
Sample No: Type: Quantity: Context:		
Sample No: Type: Quantity: Context:		

Photographs:	Drawings:
Digital Film No: Shot No's:	Plan Drawing No: Sheet No:
Slide Film No: Shot No's:	Section Drawing No: Sheet No:

Provisional Interpretation:	

The Centre for Applied Archaeology	Site: TRINITY BLACKFRIARS	Code: TB17	Fill/Layer Record Sheet (140) (005)									
	Excavated by: M.B. S.S.H.	Date: 11-18th May	Recorded by: M.B.	Date: 18/5/17								
	Grid Reference: (E, N)		Checked by:	Continued								
	Provisional Period: 19th C											
1) Texture: nat-stone & H/M brick												
2) Colour:												
3) Consistency: structure												
4) Dimensions: Length: 4m N-S } in total. Width: 4.80 E-W } Depth: not exc.												
5) Inclusions: ceramic pipe, lead pipe.												
6) Disturbance:												
7) Description and Discussion: POSS. TOILET & ALLEYWAY possible later toilet block added to W end of Cellar 1 (006) with stone flagged area to far W, possible small courtyard or alleyway. S. wall seems to be cont. of S. wall of Cellar 1 with sandy mortar. Walls aligned N-S have black ash mortar. Ceramic drain pipe cuts through. Metal pipe seems to go below stone flags. N. wall seems to be cont. of N. wall of Cellar 1. Finds from fill = late 19th - 20th c. see sketch pto.												
Stratigraphy: Stratigraphically Earlier than: 001 002 003 This context is: 005 Stratigraphically Later than: 004				Cut By: Cuts:								
Finds:	Inorganic	Pottery	Metal	Glass	Stone	Brick/Tile	Organic	Wood	Leather	Bone	Charcoal	Other
Tick if present:		✓		✓			Tick if present:					
Tick if collected:		✓		✓			Tick if collected:					
Samples:	Tick if taken: ☐						Small Finds:					
Sample No:	Type:	Quantity:	Context:									
Sample No:	Type:	Quantity:	Context:									
Sample No:	Type:	Quantity:	Context:									
Photographs:							Drawings:					
Digital	Film No:	Shot No's:		Plan			Drawing No:		Sheet No:			
Slide	Film No:	Shot No's:		Section			Drawing No:		Sheet No:			
Provisional Interpretation:												

The Centre for Applied Archaeology	Site: <u>TRINITY BLACKFRIARS</u>	Code: <u>TB17</u>	Fill/Layer Record Sheet (<u>006</u>)	
	Excavated by: <u>M.B. S.J.H. S.T.</u>	Date: <u>11-18th May</u>	Recorded by: <u>M.B.</u>	Date: <u>18/5/17</u>
	Grid Reference: (<u>E</u> , <u>N</u>)		Checked by:	Continued
	Provisional Period: <u>early 19th C.</u>			

1) Texture: <u>H/M brick</u> 2) Colour: <u>red</u> 3) Consistency: <u>structure</u> 4) Dimensions: Length: <u>3.78m E-W (interior)</u> Doorway: <u>0.75 x 0.23</u> Width: <u>3.39m N-S (")</u> Depth: <u>1.08m surviving height</u> 5) Inclusions: <u>stone flags</u> 6) Disturbance: <u>machine</u> 7) Description and Discussion: <u>CELLAR 1</u> <u>Cellar room with part brick floor + some stone flags</u> <u>has f.p. on W. wall. Bricked-up doorway (black mortar)</u> <u>in NE corner of room with staircase leading down</u> <u>from outside. Has small wall sticking out of S wall</u> <u>with black mortar. F.p. has small, single skin wall in</u> <u>centre with black mortar.</u> <u>Poss. cold-slab found on floor in SE corner of room</u> <u>Floor drain in NE corner of room</u>	Bricks: <u>23x11x7</u> Contained By:
--	---

Stratigraphy: Stratigraphically Earlier than: This context is: <u>006</u> Stratigraphically Later than: <u>004</u>	Cut By: Cuts: <u>004</u>
--	---------------------------------

Finds:	Inorganic	Pottery	Metal	Glass	Stone	Brick/Tile	Organic	Wood	Leather	Bone	Charcoal	Other
Tick if present:	☒	☒	☒	☒	☒	☐	Tick if present:	☐	☐	☐	☐	☐
Tick if collected:	☒	☒	☒	☒	☒	☐	Tick if collected:	☐	☐	☐	☐	☐

Samples:	Tick if taken: ☐	Small Finds:
Sample No: Type: Quantity: Context: Sample No: Type: Quantity: Context: Sample No: Type: Quantity: Context:		

Photographs:	Drawings:
Digital Film No: Shot No's: Slide Film No: Shot No's:	Plan Drawing No: Sheet No: Section Drawing No: Sheet No:

Provisional Interpretation:	
------------------------------------	--

Sketch Section:

Levels

TMB___: m

BS: m



FS: m

RL: m



Sketch Plan:

CELLAR 1

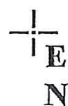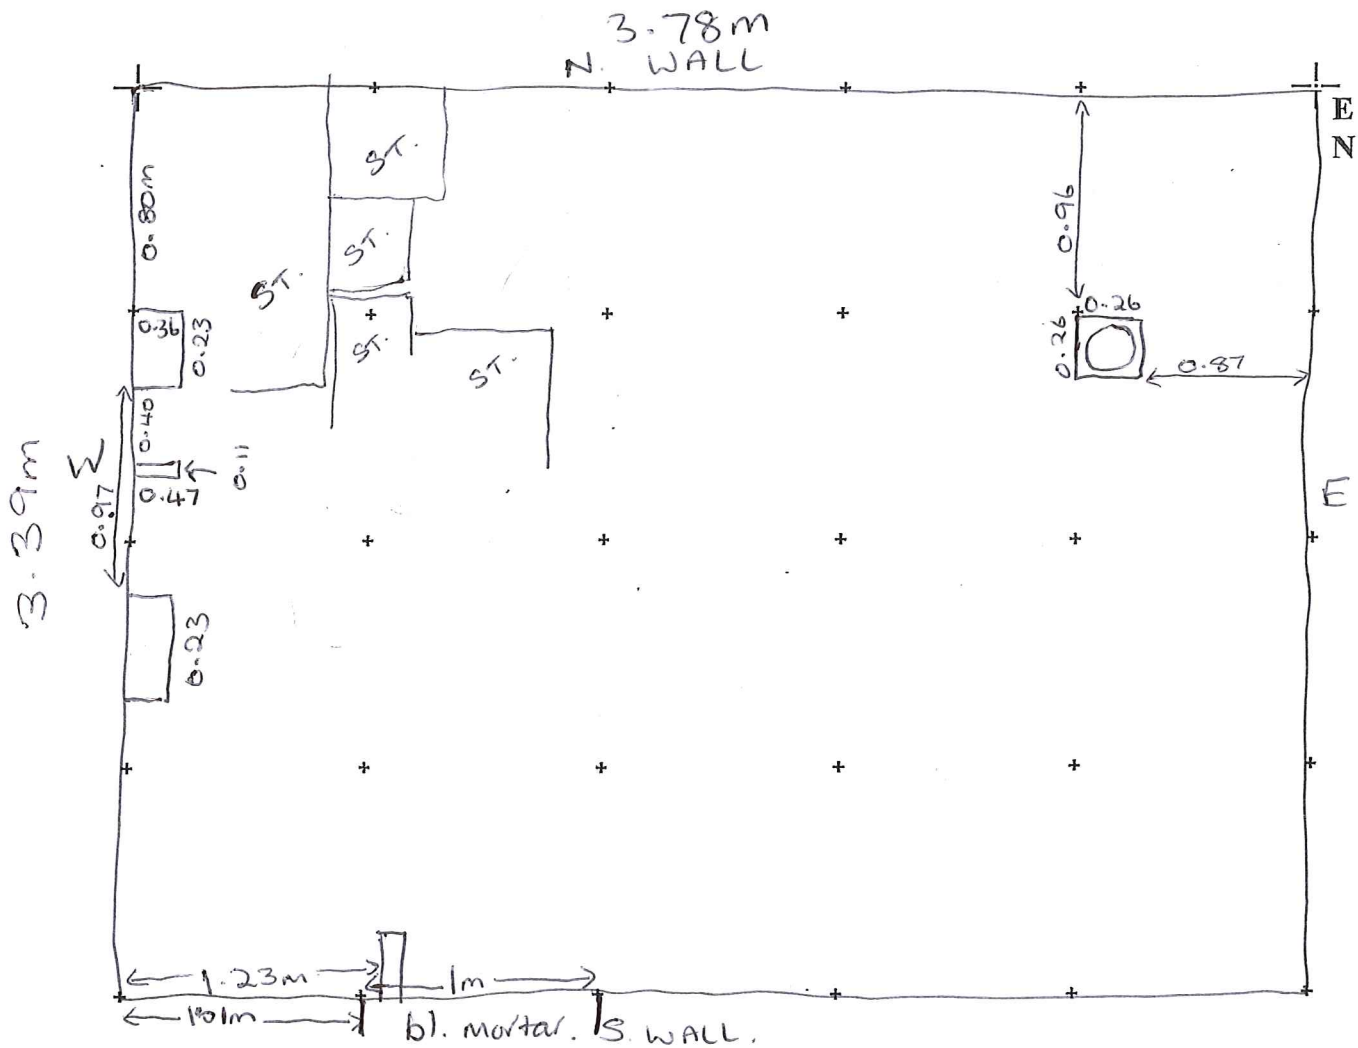

- fireplace in back room (as in H2) may not have actually been; ~~so~~ wall stub in fact to support places above.

- under ^{modern} pavement $\frac{1}{2}$ there is a store room, probably initially door + access to front of property + street; ~~door~~ later not used as entrance,

- window at back of property, conv. to use as coal shoot.

all internal dividing wall not tied in, ability
ext^{er} wall + property div. wall

- flag floor front = stairs;


- fireplace also high stairs.

- front room walls of cellar are rendered/
plastered + back room walls are whitewash.

- fireplace front room, shallow arch ~~over~~ mantel
- stone setting either side + over-mantel.
- inside fire - sloping back
- hollow wall (left); flue going into wall (right)

• window, stone sill but not evidently a coal
shed + remained part of wooden frame

Salford Archaeology Trench Record

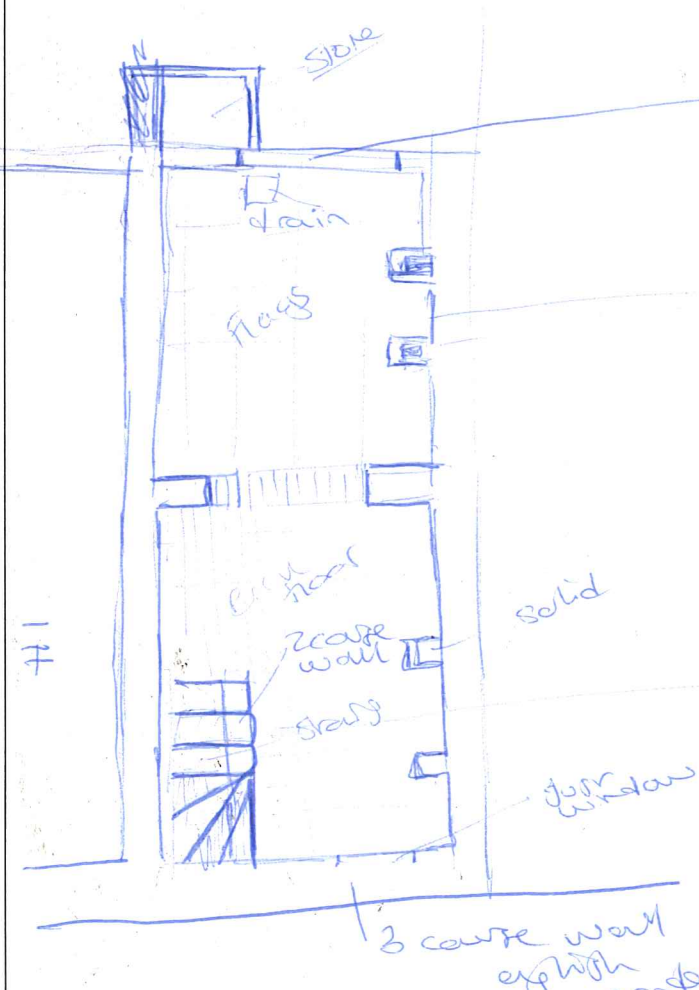Project Name:	Project Code: <u>HOUSE 2</u>	Site Code:
Alignment: <u>Rich sizes</u>	Trench No:	Sketch Plan: → stairs found intact → dividing wall is keyed-in and has some mortar as if prop^{er} walls so original → big windows to maximise light. → fireplace - flue not visible going into → stairs connect P with building same mortar
Length: <u>23m x 7m, + 11m</u>	Sketch Plan:	
Width:		
Max Depth:		
Notes/ Comments/ Summary of Contexts:		
→ basic set-up as H1 		
Compiled By:	Date:	

Trinity Blackfriars

- 001 car park surface at W. end. / Dem. rubble to E.
- 002 mot = 0.15m grey stone 0.60m yellow crushed s/stone
- 003 re-dep. clay above nat. sand / pebbles
- 004 natural sand and river pebbles - re-dep in places.





(023)
(158)
T

(026)
(161)

(003)
NAT (004)

T
(023)
(158)
WALL CUT (025)

(159)
WALL CUT (024)

ST.
DRAIN (033)
(168)
(169)
DRAIN (034)

2.20m to base.

11.85m

Room 5 (022)
(157)

drain pipe (032)
(167)

(031)
(166)
(030)
(165)

concrete foundation.

WALL 1 course wide

Room 4 (021)
(156)

conc. foundation.
1 course wide

(029)
(164)

(028)
(163)

Room 3 (020)
(155)

(027) (162)

ROAD.

